G.C.C.C. 180

REGULATION 4b (ii)

SHEET No. ~~2~~ 3 of ~~6~~ 7 SHEETS

GROUP TITLES PLAN NO. 459

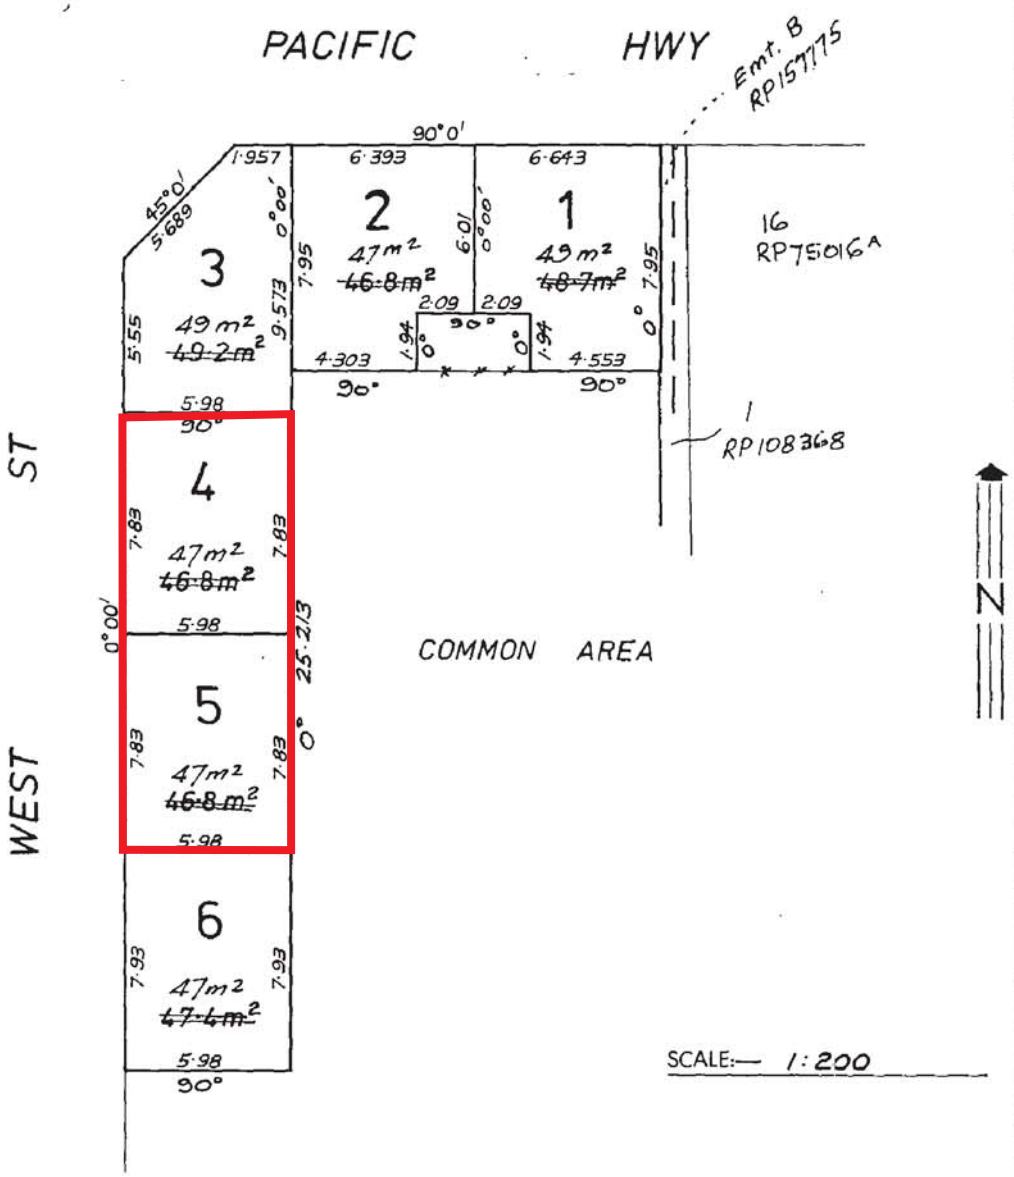

SIGNATURE OF REGISTERED PROPRIETORS:

James Foote

Kelly

~~SHIRE OF~~ TOWN CLERK

GOLD COAST CITY COUNCIL

Amendments in red by me
20/3/1980 J. Skehan L.S.